Date:

Wednesday, 06/09/2006 11:05:23 AM

User: Linda Lacelle **Process Sheet** Customer : CU-DAR001 Dart Helicopters Services **Drawing Name** : BRACKET ASS'Y Job Number \(\bar{28424}\) : 12522 **Estimate Number** : D35311 P.O. Number : NIA Part Number : UNDER REVIEW & 05.09.05 S.O. No. : NA 06/09/2006 This issue **Drawing Number** Prsht Rev. **Project Number** : SMALL /MED FAB First Issue **Drawing Revision** : NA :NA Previous Run Material **Due Date** : 13/09/2006 2 Um: Each Written By Checked & Approved By Comment : Est Rev:A New Issue 06-09.06 EC **Additional Product** PRELIMINARY ISSUE Job Number: Seq. #: Description: M6061T6S040 1.0 6061-T6 .040 Sheet Comment: Qty.: Total: 0.7944 sf(s)6061-T6 .040 Sheet (M6061T6S040) Batch: M19380 2.0 WATER JET Comment: FLOW WATER JET 1-Cut as per Dwg D3531 Dwg Rev: Pre B 09 08 Prog Rev: Pre 3.0 Comment: INSPECT PARTS AS THEY COME OFF MACHINE 4.0 QC8 Comment: SECOND CHECK

SMALL FAB 1

SMALL & MEDIUM FAB RESOURCE 1



Comment: SMALL & MEDIUM FAB RESOURCE 1

Deburr if necessary.

5.0

## **Dart Aerospace Ltd**

W/O:		WORK ORDER CHANGES										
DATE	STEP	~PRC	-PROCEDURE CHANGE			Date	Qty	Approval Chief Eng / Prod Mgr	Approval QC Inspector			
		•										
Part No		PAR #:	Fault Cate	egory:	8			Date: <u> </u>				
NCR:			VORK ORD	ER NON-CONFORM	2.00	•	u	Date:				
HOIX.	1					3i '		1				
DATE	STEP	Description of NC Section A	Initial Chief Eng	Corrective Action Sect  Action Description Chief Eng	ion B Sign Dat	& Secti	cation on C	Approval Chief Eng	Approval QC Inspector			
								٠	,			

NOTE: Date & initial all entries

•	dnesday, 06/09/2006 11:05:23 AM la Lacelle	Process Sheet
Customer:	CU-DAR001 Dart Helicopters Services	Drawing Name: BRACKET ASS'Y
/Job Number:	28424	Part Number: D35311
Job Number:		
Seq. #:	Machine Or Operation:	Description :
6.0	BRAKE NC	NC BRAKE
Comme	ent: NC BRAKE Bend as per Dwg D3530	B: 06/09/07
7.0	HAND FINISHING1	HAND FINISHING RESOURCE #1
	ent: HAND FINISHING RESOURCE #1 Chemical Conversion Coat as per QSI 00:	05 4.1
8.0	QC3	
	ent: INSPECT POWDER COAT/CHEMICAL C	
9.0	PACKAGING 1	PACKAGING RESOURCE #1
Comme	ent: PACKAGING RESOURCE #1 Identify a <del>nd Stock</del>	1. use only £ 06.09.19 3
10.0	QC21	FINAL INSPECTION/W/O RELEASE
Comme	ent; Inspection Level 21	4767107104
Job Completion		L 06.09:20
000	WENT TO HAL. PAR	T NOT APPROVED AND NOT ALRWORTHY
A bec.		7.07.13
		•
(		

Dart	Ae	ros	pace	Ltd
------	----	-----	------	-----

W/O:		WORK ORDER CHANGES									
DATE	STEP	PROCEDURE CHANGE	Ву	Date	Qty	Approval Chief Eng / Prod Mgr	Approval QC inspector				
16-09-07	6.1	QCS regid for bud inspection. Perm. Change									
		QC 5 inspect bend.	0	06-09-07	2		06 0907				


	<del>!</del>	<del></del>							
Part No	:	PAR #:	Fault Catego	ory:	NCI	R: Yes No	DQA:	_ Date: _	
						QA: N/C	Closed:	_ Date: _	
NCR:		\	WORK ORDE	R NON-CONFO	RMANCE	(NCR)			
DATE		Decemention of NC		Corrective Action Section B			\/:\C:4\:		
	STEP	Description of NC	Initial	Action Descrip	otion	Sign &	Verification	Approval	Approva

		Description of NC		Corrective Action Section B			A	Ammenical
DATE	STEP	Section A	Initial Chief Eng	Action Description Chief Eng	Sign & Date	Verification Section C	Approval Chief Eng	Approval QC Inspector
		* :						
								• )

NOTE: Date & initial all entries

# PRELIMINARY ISSUE

DESIGN DRAWN BY DART AEROSPACE LTD HAWKESBURY, ONTARIO, CANADA CHECKED APPROVED DRAWING NO. REV. A D3531 SHEET 2 OF 3 DATE TITLE SCALE 06.06.21 **BRACKET ASSEMBLY** 1:3

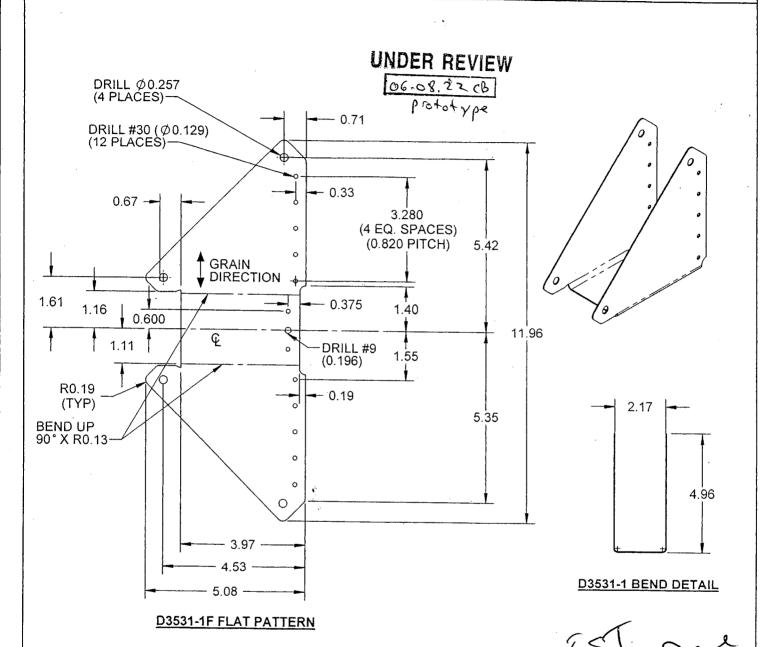

## D3531-1 BRACKET

#### NOTES:

- 1) MATERIAL: 6061-16 ALUMINUM (QQ-A-250/11) 0.040 SHEET (REF DART-SPEC. M6061T6S.040)
  2) FINISH: ACID ETCH AND ALODINE PER DART QSI 005 4.1
- 3) TOLERANCES ARE PER DART QSI 018 UNLESS OTHERWISE NOTED
- 4) ALL DIMENSIONS ARE IN INCHES
- BREAK ALL SHARP EDGES 0.005 TO 0.010
- 6) PART IS SYMMETRICAL ABOUT Q

#### COPYRIGHT © 2006 BY DART AEROSPACE LTD.

DART AEROSPACE LTD	Work Order:	28424
Description:	Part Number:	3531-1
Inspection Dwg: \Rev:		Page 1 of 1

## FIRST ARTICLE INSPECTION CHECKLIST

X	First Article	X	Prototype
X	First Article	X	Prototype

Drawing Dimension	Tolerance	Actual Dimension	Accept	Reject	Method of Inspection	Comments
	+1-0.005,0.000	0.857	$\checkmark$	N 1 .	VerN	
\$ 0.129	+1-0.005,0.000	0.130	✓		vern	
D 196	41-0.005, 0.000	0.196	<b>V</b>		vern	
5.08	+1-0.030	5.10	<u> </u>		VEFN	
11.96	4-0.030	11.96	./		Measuring 4	pe
3.97	41-0.030	3.98	1		vern	
4.53	+1-0.030	4.53	<b>✓</b>		VERN	
	•.			-		
		· · ·		·		
					•	
						No. 1
				ų ė		
·						·
						·
				<del> </del>		
		4				

Measured by:	Audited by:	Prototype Approval:
	Date:	. Date:
Date: B of B		

Rev	Date	Change		provea
Α		New Issue	· KJ/JLM	

KEURINGSRAPPORT COPPER AND BRASS SALES CORPORATE SERVICES DIVISION KLANT SOUTHFIELD, MI USA UW ORDERNUMMER ONS ORDERNUMMER DOCUMENT NUMMER P03944 (COPPER'S PO#CC1837) 58848/01 V/0080151422 SPECIFICATIES: ALU SHEETS (STENC.) AA 60612T6
AFMETINGEN: 144" X 48" X 0.04"
ARTIKEL NR.: Corus Aluminium N.V. A. Stodettaan 87, 2570 Duffel - Belgium Tel. 32 (0)15 30 21 11 - Fax (0)15 30 27 94 CHEMISCHE ANALYSE (%) ROL-GEUT-NUMMER NUMMER ------0,04 0,35 0,15 0,25 0,15 0,09 0,09 0,02 0,01 7124901 0,67 001 O, OL 7124901 002 0,05 MAX 0,15 MAX ANDERE : ELK TOTAAL MECHANISCHE EIGENSCHAPPEN 1 N/MM2 = 1 MPA = 0.1 HBAR = 0.102 KG/MM2 = 0.145 KSI /A = ACHTER /M = MIDDEN /V = VOOR /O = RANDOM NUMMER RM RP02 KSI KSI 35 10 42 XAM 16 15 16 16 16 39 39 39 COPPER AND BRASS SALES 002 SOLD TO:

BY:

PROD. REF. : 0000175932/001

NRBST : 58848/01

PAGINA :

Corus Aluminium Rolled Products - Corus Aluminium Extrusions

DOC: V/0080151422

DATUM : 2005-04-18